


00 FORM 1 APR 54 1176

NOTES:—When Government drawings, specifications, or other data are used for any purpose other than in connection with a specifically related Government procurement contract, the United States Government thereby incurs no responsibility for any alterations, omissions, or errors; and the fact that the Government may have furnished, furnished, or supplied the said drawings, specifications, or other data in any way is not to be regarded as an endorsement or approval of any commercial product, name, or any other person or organization, or as carrying any rights of patent or trademark, or as, or all, any representation that may in any way be related thereto.

# NOTES:

1. ALL EDGES SHALL BE BROKEN .002+.005 UNLESS OTHERWISE SPECIFIED.
2. FINISH 125 EXCEPT SHEARED OR STAMPED EDGES 250.
3. MIL-W-13855 SHALL APPLY.

REVIEWS		DATE	APPROVAL
A	REDRAWN AND REVISED SEE	12 JUN 58	<i>R. B. Henry</i>
B	SEE EO SA 24622	1 SEP 58	<i>R. B. Henry</i>
C	SEE EO SA 25196	11 MAR 63	<i>R. B. Henry</i>
D	(1) SEE EO SA 26221	18 MAY 66	<i>R. B. Henry</i>
E	SEE EO 82048	11 MAR 68	<i>R. B. Henry</i>
F	(1) SEE EO HRD 92078-2	25 JUN 68	<i>R. B. Henry</i>
G	SEE EO HRD 02138	7 FEB 75	<i>R. B. Henry</i>
H	(3) SEE ERR HQR 40681	10 FEB 75	<i>R. B. Henry</i>
J	NOR W8S2022/79-03-26	79-04-01	<i>R. B. Henry</i>

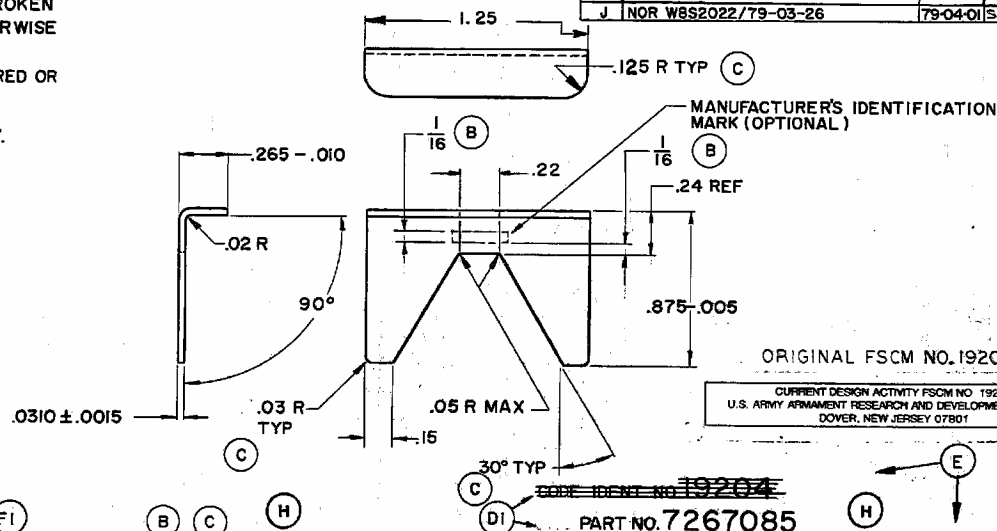

ORIGINAL FSCM NO. 19205

CURRENT DESIGN ACTIVITY FSCM NO. 19200  
U.S. ARMY ARMAMENT RESEARCH AND DEVELOPMENT CENTER  
DOVER, NEW JERSEY 07801

PART NO. 7267085

PHYSICAL PROPERTIES		UNLESS OTHERWISE SPECIFIED		ORIGINAL DATE OF DRAWING	
YP		DIMENSIONS ARE IN INCHES		18 OCT 54	
TS		TOLERANCES ON FRACTIONS DECIMALS ANGLES		DRAFTSMAN A.K. CHECKER J.K.	
EL2		± 1/64 ± .01 ± P		TRACER C. 77 L.C. CHECKER J.K.	
RA		MATERIAL: STEEL SPEC Q.Q. S-698 CARBON 08/19, KILLED, DRAWING QUALITY.		ENGINEER <i>R. B. Henry</i> ENGINEER <i>R. B. Henry</i>	
RM		HEAT TREATMENT AT ASSEMBLY		APPROVED BY ORDER OF THE CHIEF OF BUREAU <i>R. B. Henry</i>	
RM		FINAL PROTECTIVE FINISH AT ASSEMBLY		<i>H. F. Lynch</i>	

STOP,  
FOLLOWER

DEPT. OF THE ARMY  
~~ROCK ISLAND~~  
~~ARMORY~~  
ROCK ISLAND, ILL. 61201

DWG NO. 7267085  
B SHEET 1 OF 1

RMH